



Montana Department of
ENVIRONMENTAL QUALITY

MAILED

4-8-11 *jh*

Brian Schweitzer, Governor
Richard H. Opper, Director

P.O. Box 200901 • Helena, MT 59620-0901 • (406) 444-2544 • www.deq.mt.gov

April 7, 2011

Mr. Todd Kuxhaus
GREAT WEST ENGINEERING
PO Box 4817
Helena, MT 59604

**RE: CLOSED CITY OF HELENA LANDFILL
POST-CLOSURE PLAN ADDENDUM - APPROVAL**

Dear Todd,

The Solid Waste Program (SWP) has reviewed your request to amend the Post-Closure Plan for the above noted facility. Specifically, you requested approval to relocate the Freeride Park due to site limitations. The request is approved, but conditioned upon the requirement to obtain approval from the SWP in advance of any excavation activities within these freeride areas.

Thank you for your patience. Please do not hesitate to contact me with any questions, comments, or concerns.

Sincerely,

Mary Louise Hendrickson
Solid Waste Program – Licensing
Phone: 406-444-1808; Fax: 406-444-1374
Email: mhendrickson@mt.gov

File: **Lic#90/Class II Landfill/City of Helena/Post Closure**
Path: G:\WUT\SWS\closure\helena\CentennialPark-FreerideParkLocation.docx

MAILED

Stepp, Tim

From: Stepp, Tim
Sent: Wednesday, October 13, 2010 2:05 PM
To: 'Todd Kuxhaus'; Hendrickson, Mary
Cc: ateegarden@ci.helena.mt.us; Gery Carpenter; Nathan Steiner
Subject: RE: Centennial Park - Encountered Waste Notification
Attachments: image002.png; image001.png

Todd,

Thanks for the notification.
The deviation for installation in those areas is approved.
Please include the deviation info in the QA/QC report.

Tim

TIM STEPP

Environmental Engineer - Solid Waste Program
Waste & Underground Tank Management Bureau
Permitting & Compliance Division



Lee Metcalf Building
1520 East Sixth Ave
P.O. Box 200901
Helena, MT 59620-0901

Phone 406-444-4725
Fax 406-444-1374
email: tstepp@mt.gov

From: Todd Kuxhaus [<mailto:tkuxhaus@greatwestern.g.com>]
Sent: Wednesday, October 13, 2010 11:25 AM
To: Stepp, Tim; Hendrickson, Mary
Cc: ateegarden@ci.helena.mt.us; Gery Carpenter; Nathan Steiner
Subject: Centennial Park - Encountered Waste Notification

Mary and Tim,

Yesterday, we hit some more garbage at the site. This time it was at two locations near the north end of the new YMCA parking lot. One location is along a storm drain trench, the other was at the bottom of a light pole base. We have proceeded in accordance with the details of the post-closure plan utilizing GCL and fine grained material as pipe bedding/backfill. Also, all removed waste has been hauled to the transfer station. We have documented the location and materials used to repair the areas.

Please let me know if you require anything further.

Thanks,

Todd K. Kuxhaus, PE | Project Manager

Great West Engineering, Inc.

PO Box 4817
2501 Belt View Drive
Helena, MT 59604

PHONE: 406-449-8627
DIRECT: 406-495-6167
FAX: 406-449-8631

10/13/2010

Stepp, Tim

Handwritten: 7/1/2010

From: Todd Kuxhaus [tkuxhaus@greatwesteng.com]

Sent: Thursday, July 01, 2010 7:52 AM

To: Hendrickson, Mary

Cc: Gery Carpenter; Nathan Steiner; Leland, Rob (Helena Sand & Gravel); Stepp, Tim; Ben Sautter

Subject: Centennial Park

Mary,

As you may have noticed, Helena Sand and Gravel is making good progress importing fill to the site. Beginning on July 6, 2010, they will begin cutting material from the western portion of the site. Although we have designed the grading to be above the top of the municipal waste, there is still a chance we will encounter some waste during cutting. Cutting operations should last about 10 working days. I wanted you and your group to be aware that if we hit municipal waste we will be contacting you as per the requirements of the post-closure plan. I hoping that a member of your group would be available if this occurs to minimize construction delays.

Please give me a call if you have any questions or concerns.

Thanks,

Todd K. Kuxhaus, PE | Project Manager

Great West Engineering, Inc.

PO Box 4817

2501 Belt View Drive

Helena, MT 59604

PHONE: 406-449-8627

DIRECT: 406-495-6167

FAX: 406-449-8631

7/2/2010

Page 1

11/1/20

From: [illegible]
To: [illegible]
Subject: [illegible]

[illegible text block]

[illegible text block]

Montana Department of
ENVIRONMENTAL QUALITY

MAILED

5-13-10 Jh

Brian Schweitzer, Governor
Richard H. Opper, Director

P.O. Box 200901 • Helena, MT 59620-0901 • (406) 444-2544 • www.deq.mt.gov

May 12, 2010

Mr. Ryan Leland, P.E.
City of Helena Engineer
316 N. Park
Helena, MT 59623

RE: CONSTRUCTION APPROVAL—HELENA CENTENNIAL PARK
Closed City of Helena Class II Landfill (Lic. # 90)

Dear Ryan:

The Department of Environmental Quality (Department) has reviewed the construction bid documents submitted for the Centennial Park Project at the subject facility.

The Department approves construction of the Centennial Park as proposed.

Please notify Mary Louise Hendrickson (406-444-1808), if waste is encountered during excavation and grading. We look forward to the final QA/QC Report upon completion of the project.

For assistance, please contact me at the Permitting and Compliance Division: Voice 406-444-4725 or email tstepp@mt.gov.

Sincerely,

Tim Stepp
Engineer, Solid Waste Program
Waste & Underground Tank Management Bureau

Cc: Amy Teegarden, Director, City of Helena Parks (address above)
Ben Sautter, Superintendent, City of Helena Solid Waste (address above)
Todd Kuxhaus, P.E., Great West Engineering, P.O. Box 4817, Helena, MT 59604

File: Lic#90/Class II Landfill/City of Helena/Post Closure
Path: G:\WUT\SWS\closure\helena\CentennialPark-constApprov0510.doc



**Montana Department of
ENVIRONMENTAL QUALITY**

MOILED
12-31-09

Brian Schweitzer, Governor

P.O. Box 200901 • Helena, MT 59620-0901 • (406) 444-2544 • www.deq.mt.gov

December 30, 2009

Mr. Ryan Leland, P.E.
City of Helena Engineer
316 N. Park
Helena, MT 59623

COPY

**RE: APPROVAL—LANDFILL FINAL USE / HELENA CENTENNIAL PARK
Closed City of Helena Class II Landfill (Lic. # 90)**

Dear Ryan:

The Department has completed its review of the Post-Closure Plan (PCP) and 95% construction documents submitted for the Centennial Park Project to modify the final cover and post-closure final use of the closed City of Helena Class II Landfill. We appreciate that the City has adequately addressed all of the previous comments on the draft PCP and design documents.

The landfill Post-Closure Plan and project documents for Centennial Park are approved for construction on the landfill final cover with the following minor additions/corrections:

- (1) Please add a note to the Special Provisions paragraphs 1.3 (Section 01000-Page 2) directing the QA engineer to contact me (406.444.4725) at the Department if a significant thickness of solid waste or any methane control/monitoring utilities are encountered in the parking lot or any other grading operations during construction.
- (2) Correct Water/Sewer Trench detail to show GCL below pipe on Sheet C-33.
- (3) Correct Liner Penetration detail to show PVC boot welded to PVC liner around pipe.
- (4) Correct Liner Penetration detail to show bentonite seal around pipe contact with liner.

We approve the use of asphalt as final cover in the extended parking lot areas, as long as tensional cracks remain adequately sealed annually. Detail on Sheet C-33 shows approved repair of cap if waste is encountered during other grading. Please add details in the as-built drawings for the already constructed extension of the methane collection trench adjacent to the Armory. Also add the extended methane trench testing to the final project QA/QC Report upon completion.

Thanks for your fine cooperation and assistance. Please feel free to contact me at the Permitting and Compliance Division for assistance: Voice 406.444.4725 or email tstepp@mt.gov.

Sincerely,

Tim Stepp
Engineer, Solid Waste Program
Waste & Underground Tank Management Bureau

Cc: Amy Teegarden, Director, City of Helena Parks; Ben Sauter, Superintendent, City of Helena Solid Waste
File: Lic#90/Class II Landfill/City of Helena/Post Closure
Path: G:\WUT\SWS\closure\helena\CentennialPark-FinalCoverMod1209.doc



Montana Department of
ENVIRONMENTAL QUALITY

MAILED

6-17-09

Brian Schweitzer, Governor

P.O. Box 200901 • Helena, MT 59620-0901 • (406) 444-2544 • www.deq.mt.gov

June 15, 2009

Rich Lynd
Parks Superintendent
316 N. Park
Helena, MT 59623

COPY

RE: HELENA SKATE PARK EXPANSION—FINAL COVER INSPECTION
City of Helena Class II Landfill (Lic. # 90)

Dear Mr. Lynd:

The City of Helena notified the Department that construction of the Helena Skate Park expansion had commenced, being located immediately adjacent to the closed City of Helena Class II landfill. On June 11, 2009, I met on site with you and Amy Teegarden to inspect the material uncovered during backhoe excavation of the subgrade surrounding the park on the north side of the YMCA building.

Verbal approval was given on site to proceed with construction of the Helena Skate Park expansion as planned. All construction lies outside the final cover of the landfill, but waste flanks the skate park area beneath the road on the immediate northern and western margins. On-site soils were approved for embankments and trench backfill. Permission was given to bury the abandoned well EW-6 (replaced by extraction well EW-7). The YMCA methane extraction trench was staked and well marked to avoid its disturbance during construction.

A trace of largely inert debris was intermixed with the soil along this poorly defined eastern edge of the landfill final cover located between the YMCA and the Old Glory Memorial site. Very thin horizons of dispersed ash lie within the upper foot, presumably locating the burn area for the final landfill phase (on-site verbal Jodi Bingham). The NW terminus of the northern-most stormwater pipe trench locates the edge of the waste boundary and final cover of the landfill. Swales in the curb along the northern edge of the road indicate that the edge of the landfill heads south from Old Glory and turns abruptly west and then turns abruptly south along the northern and western edges, respectively, of the Helena Skate Park. The southern boundary of the park expansion lies immediately adjacent to methane extraction wells EW-7 and EW-8.

Thank you for the notification of construction. Please feel free to contact me at the Permitting and Compliance Division for assistance: Voice 406.444.4725 or email tstepp@mt.gov.

Sincerely,

Tim Stepp
Solid Waste Program
Waste & Underground Tank Management Bureau

Encl: Field Inspection Form
Cc: Amy Teegarden, Director of Parks and Recreation; Jodi Bingham, Consultant
Martin Van Oort, DEQ Solid Waste
File: Lic#90/Class II Landfill/City of Helena/General Correspondence
Path: G:\WUT\SWS\engineering\helena\SkateParkExpn0609.doc

Date: 6/11/09
Time of Arrival: 11:30 AM
Time of Departure: Noon
Total Hours: 1 hr

SOLID WASTE MANAGEMENT SITE/SYSTEM - ON-SITE OBSERVATION FORM
(This is not the Notice of Violation mentioned in Section 75-10-227, MCA)

Facility Name Helena Skateboard Park License No. #90
Solid Waste Management Site/System Description City of Helena
Location Park fringes E flank of Old City Class II final cap
Owner City of Helena Phone _____
Address _____ City _____, MT _____
Operator N/A Phone _____
Address _____ City _____, MT _____
Landfill Representative(s) Present Paul Reed Title Park Supt.
City Any Tugader, Jodi Bingham Title _____
DEQ Representative(s) Present Tim Stepp Title SWP engineer.
Title _____

(Answer all questions; mark N/A if not applicable; please print)


A. General Operational and Maintenance Requirements

Yes No N/A

1. Operational Records located where? _____
2. Dumping confined to a manageable area? [ARM 17.50.510(4)] _____
3. Refuse properly covered after each operating day? [ARM 17.50.511(1)(a)] _____
 - a) Alternative Daily Cover in use? [ARM 17.50.511(1)(a)] _____
 - b) If so, what kind? _____
4. If a Class III landfill, covered at least quarterly? [ARM 17.50.511(2)] _____
5. Daily Spreading and compaction of refuse adequate? [ARM 17.50.511(1)(a)] _____
6. Depth, spreading, and grading of intermediate cover adequate? [ARM 17.50.511(1)(a)] _____
7. Final cover on filled areas? [ARM 17.50.530(1)(a)] Final cover undisturbed: _____
8. Rodents and insects controlled? [ARM 17.50.510(7)] X _____
9. Blowing litter controlled? [ARM 17.50.510(6)] _____
10. Access to site controlled? [ARM 17.50.510(4) and (5)] _____
Sign(s) _____ Gate(s) _____ Fences(s) [ARM 17.50.511(1)(c)] _____ Supervision _____
(Check all that apply)
11. Approach road properly maintained? [ARM 17.50.505(1)(b)] _____
12. Solid Waste Management facility equipment visible on-site? _____
 - a) If so, what kind(s) _____
13. Salvaging going on? [ARM 17.50.510(8)] _____
 - a) Approved salvaging plan on-file with DEQ? _____
14. What method is used to measure waste volumes? [ARM 17.50.511(1)(c)] _____

a) How often is volume measured? _____

NOTES: Jodi Bingham - oversight contractor
200' crest intercepted ash in "burn area" where skate park is located
3 Methane trenches intercepted some burn ashes but no MSW
★ EW-6 may be abandoned & backfilled & b/c replaced by edj EW-7
★ On-site fill may backfill trenches & raise embankments
Minor ~ 1ft cut on S margin of concrete shows & tree brick debris
Deepest 4ft cut on NW corner @ stormwater pipe
hit mixed waste tank
City of Helena
6/11/09

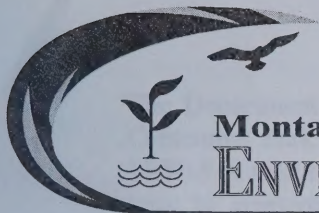

**Montana Department of
ENVIRONMENTAL QUALITY**

MAILED
5-21-08 gh

Brian Schweitzer, Governor

P.O. Box 200901 • Helena, MT 59620-0901 • (406) 444-2544 • www.deq.mt.gov

May 20, 2008

Mr. Kevin Harrington
CITY OF HELENA – ENGINEERING DIVISION
316 North Park – Room 417
Helena, MT 59624

RE: Closed City of Helena Landfill – License #90
Proposed Centennial Park Preliminary Enhancements
Investigation to Determine the Location of Historic Garbage
Approval to Proceed

Dear Mr. Harrington:

The Department of Environmental Quality (Department) has reviewed the request, submitted on your behalf by Robert Peccia & Associates, to resume the site excavation and grading work at the closed City of Helena Landfill. The Department approves the resumption of activities with the following conditions:

- Prior to the removal of additional fill material from the current project area, the City must determine the depth to and areal extent of the historic garbage. Your request to resume activities included a map of the proposed test pit locations. The test pit locations are approved. During the investigation, work shall proceed as follows:
 - The overlying fill material at each test pit location shall be removed in lifts no greater than 6-inches deep;
 - To ensure that the lower explosive limit (LEL) of landfill gas is not exceeded in the vicinity of the test pits during excavation, the methane concentrations must be monitored when personnel are working in the area;
 - When historic garbage is discovered, excavation activities will be halted until the location and elevation of the garbage is determined. The location coordinates and elevation measurements must be recorded and provided to the Department upon completion of the project. The depth of continued site excavation and grading will be determined by the Department once the elevation of historic garbage has been established. The approval for continued excavation and site grading will be provided in a separate letter to the City.

RECEIVED

UNITED STATES DEPARTMENT OF AGRICULTURE
BUREAU OF PLANT INDUSTRY

Washington, D. C.

For the purpose of this report, the following information was obtained from the records of the Bureau of Plant Industry:

The following information was obtained from the records of the Bureau of Plant Industry:

The following information was obtained from the records of the Bureau of Plant Industry:


The following information was obtained from the records of the Bureau of Plant Industry:

The following information was obtained from the records of the Bureau of Plant Industry:

The Department is aware that the City proposes to develop the closed landfill as the Centennial Park recreational complex. The Administrative Rules of Montana (ARM) 17.50.531 require Department approval for all post-closure uses. In addition, these uses must be approved prior to implementation. The currently planned post-closure use was not part of the facilities post-closure use plan. Therefore, the Department requires the submittal of a post-closure plan that demonstrates the proposed post-closure use will not disturb the integrity of the final cover, liner(s), or any components of the containment system, or the function of the monitoring systems. The updated post-closure plan should include a Site Master Plan and design details as well as the measures to be implemented to ensure the security of the landfill groundwater and methane monitoring and extraction systems.

If you have any questions regarding this approval, or require further information regarding the submittal of the updated post-closure plan, please do not hesitate to contact me directly at the Permitting and Compliance Division, Waste and Underground Tank Management Bureau, Solid Waste Program.

Respectfully,

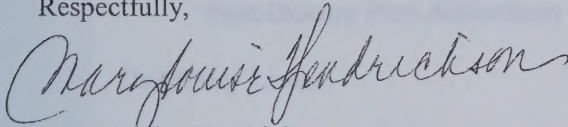

Mary Louise Hendrickson

Project Lead

Solid Waste Licensing

Phone: 406-444-1808; Fax: 406-444-1374

Email: mhendrickson@mt.gov

File: Closed Landfills\L&C County\Closed City of Helena\#90\Closure and Centennial Park

Path: G:\WUT\SWS\closure\lewisClark\ClosedHelena-WasteDepthInvstgtn-apprvl.doc

cc: Mr. John Piccone, Robert Peccia & Associates, PO Box 5653, Helena, MT 59604

Mr. John Rundquist, City of Helena, 316 N. Park, Helena, MT 59624

Mr. Ben Sautter, City of Helena, 316 N. Park, Helena, MT 59624

Mr. Mike Wignot, Hydrometrics, Inc., 3020 Bozeman Ave., Helena, MT 59601

Mr. Rich Lynd, City of Helena Parks Dept., 340 Neil Avenue, Helena, MT 59623

HELENA

PO Box 4817 ■ 2501 Belt View Drive
Helena, MT 59604
406.449.8627 ■ Fax 406.449.8631



January 7, 2011

RECEIVED ON
JAN 12 2011

Mary Louise Hedrickson
Montana Department of Environmental Quality-Solid Waste
PO Box 200901
Helena, MT 59620-0901

Dept. of Environmental Quality
Waste & Underground
Park Management Bureau

**RE: Closed City of Helena Landfill
Post-Closure Plan Addendum**

Dear Mary Louise:

Through the course of construction, site limitations have resulted in the need to relocate the bicycle freeride park. The attached exhibit shows this new proposed location.

We are therefore, requesting approval of this new freeride park location. If you have any questions or comments please contact me.

Sincerely,

Great West Engineering, Inc.

Todd Kuxhaus, PE
Project Manager

Enclosures: Freeride Exhibit

Cc: Amy Teegarden - City of Helena
Gery Carpenter - City of Helena
Nathan Steiner - Carl Thuesen

BILLINGS

115 N Broadway
Suite 500
Billings, MT 59101
406.652.5000
Fax 406.248.1363

BOZEMAN

602 Ferguson
Suite 1
Bozeman, MT 59718
406.587.0504
Fax 406.587.0541

OFFICE

RECEIVED ON

JAN 1 1961

Dept. of Environmental Control
Water & Pollution
Sanitation Division

Sanitation Division

Sanitation Division
Water & Pollution
Sanitation Division

Sanitation Division

Water & Pollution
Sanitation Division

RECEIVED ON

JAN 12 2011

Dept. of Environmental Quality
Waste & Underground
Tank Management Bureau

RECEIVED ON

JAN 12 1961

Dept. of Environment, Quality
Air & Land
Land Management Division

Form 1-100

State of California
Department of Environment, Quality
Air & Land
Land Management Division

TO: Director, Department of Environment, Quality
Air & Land

FROM: [Illegible]

Subject: [Illegible]
Reference: [Illegible]
Enclosure: [Illegible]

Date: [Illegible]

Very truly yours,
[Illegible Signature]

Enclosure

cc: [Illegible]
[Illegible]
[Illegible]

NOTE:
1. EXHIBIT IS PROVIDED TO SHOW THE OVERALL CHANGE IN LOCATION
OF THE FREERIDE EVENT. FREERIDE ELEMENTS SHOWN ARE CONCEPTUAL
AND DO NOT REPRESENT THE FINAL DESIGN OR FINAL LOCATION OF
THE ELEMENTS.




Centennial Park
FREERIDE EXHIBIT:
LOCATION ADJUSTMENT

RECEIVED
JAN 12 2011
DEPT. OF ENVIRO. QUALITY
WASTE & UNDERGROUND TANK
MANAGEMENT BUREAU

CARL THUESEN
A S L A
GOLF COURSE ARCHITECTURE
LANDSCAPE ARCHITECTURE
1925 GRAND AVE. SUITE 105
P.O. BOX 22943
BILLINGS, MT 59104
406/252-5545 FAX 245-9855

Drawn by: NGS
Date: 12/20/10
Checked by: NGS
Date: 12/20/10
Rev: -
Rev: -
File: -

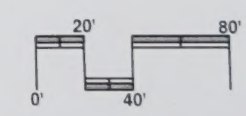



August 14, 2008

Mr. Mike Friend
Engineering Technician
City of Helena
City/County Building
316 North Park Ave.
Helena, MT 59623

mlh
RECEIVED
AUG 18 2008
Dept. of Enviro. Quality
Waste & Underground
Tank Management Bureau

Dear Mike,


I have reviewed the plans for the Helena Skate Park expansion and would like to submit the following comments:

- Sheet L1: The location of the gas extraction system control boxes does not match our survey data of these locations. I have included a figure showing their actual location in relation to the YMCA and blower building with an underlay of the skate park design. If you would like a copy of our survey data, please let me know.
- Sheet L1: The irrigation control box located just to the south of the gas extraction system marked for removal is actually part of the gas extraction system and should NOT be removed by the Parks Department.
- Sheet L3: The new bowl located in the southwest corner of the project is over the top of the gas extraction system main line. Could we move the bowl slightly to the west to avoid construction over the top of the main?
- Sheet L4: The drain lines for the two new bowls cross the landfill gas main in two places. I would like to special notations on the drawing warning the contractor to be especially careful excavating in these areas.
- Sheet L8: Detail I shows a general valve box detail for the gas extraction system, but the location of this box is never shown on the drawings. Rather than a valve box, I would recommend that we put a riser on the extraction well and relocate all the controls to the new higher elevation and then reconnect to the main. This would allow us easy access for monitoring the extraction system without resorting to

confined space entry procedures. If you would like us to provide detail drawings for this portion of the work, please let us know.

Please call if you have any questions.

Sincerely,

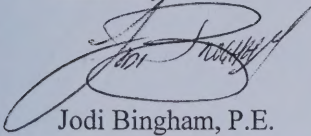A handwritten signature in black ink, appearing to read 'Jodi Bingham', is written over a circular stamp or seal.

Jodi Bingham, P.E.
Environmental Engineer/Chemist

Enclosure

c: Mr. John Rundquist, City of Helena
Mr. Ben Sautter, City of Helena
Ms. Amy Teegarden, City of Helena
Mr. Mike Wignot, Hydrometrics
Ms. Mary Louise Hendrickson, MDEQ

the portion of the waste stream to be treated

to meet the effluent quality




The waste stream is treated

to meet

The effluent quality is maintained
at a level of 100 mg/l of BOD
and 10 mg/l of suspended solids
in the effluent stream

The effluent quality is maintained

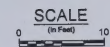

EXISTING
PARKING LOT

GRADING NOTES

- # GRADING NOTES
1. THIS PLAN PROVIDES GENERAL GRADING INFORMATION. ALL SURVEYING SHALL BE THE RESPONSIBILITY OF THE CONTRACTOR.
 2. EXPORTATION OF SOIL, WHICH MAY BE NECESSARY TO MEET THE GRADIES SHOWN ON THIS PLAN, SHALL BE THE RESPONSIBILITY OF THE CONTRACTOR AND SHALL BE PART OF THIS CONTRACT.
 3. CONTRACTOR SHALL BE RESPONSIBLE FOR VERIFICATION OF THE LOCATION OF ALL EXISTING UTILITIES IN THE FIELD. LOCATIONS SHOWN ON THE PLANS ARE APPROXIMATE AND FOR GENERAL INFORMATION ONLY.
 4. ALL HIGH POINTS, LOW POINTS OR GRADE BREAKS ON CONCRETE SURFACES SHALL HAVE A SMOOTH CURVE. CONCRETE SHALL NOT BE BUILT TO A POINT.
 5. THE CONTRACTOR SHALL MATCH THE NEW GRADES WITHIN THE LIMITS OF UNITS ACCEPTED. REFER TO CITY REQUIREMENTS FOR SPECIFICS.
 6. CONTRACTOR SHALL PROVIDE SECURITY BARRIER DURING CONSTRUCTION & DAMAGE BEHIND WALLS & TRANSITION RAMP IS AT THE DISCRETION OF THE CONTRACTOR.
 7. DRAINAGE BEHIND WALLS & TRANSITION RAMP IS AT THE DISCRETION OF THE CONTRACTOR.
 8. DRAINAGE BEHIND WALLS & TRANSITION RAMP IS AT THE DISCRETION OF THE CONTRACTOR.

DRAWING FILE NUMBER	
127303H001	
AUTOCAD 2004 DRAWING (DWG)	
SHEET NUMBER	REV
	△

subject of the work is the...
the purpose of the work is to...

It is the purpose of this work to...



For further information...

1

Page 1

The first part of the work...
the first part of the work...
the first part of the work...
the first part of the work...
the first part of the work...



DESCRIPTION	ITEM	IE	HP	EG	EXISTING GRADE	EROSION CONTROL FENCE	STORM DRAIN LINE	SLOPE DIRECTION	6" FLOOD DRAIN	PROPOSED SAWCUT LOCATION	SKATEPARK LIMITS OF CONSTRUCTION
RIM ELEVATION	HP	IE	HP	EG	EXISTING GRADE	EROSION CONTROL FENCE	STORM DRAIN LINE	SLOPE DIRECTION	6" FLOOD DRAIN	PROPOSED SAWCUT LOCATION	SKATEPARK LIMITS OF CONSTRUCTION
INVERT ELEVATION	HP	IE	HP	EG	EXISTING GRADE	EROSION CONTROL FENCE	STORM DRAIN LINE	SLOPE DIRECTION	6" FLOOD DRAIN	PROPOSED SAWCUT LOCATION	SKATEPARK LIMITS OF CONSTRUCTION
HIGH POINT	HP	IE	HP	EG	EXISTING GRADE	EROSION CONTROL FENCE	STORM DRAIN LINE	SLOPE DIRECTION	6" FLOOD DRAIN	PROPOSED SAWCUT LOCATION	SKATEPARK LIMITS OF CONSTRUCTION
EROSION CONTROL FENCE	HP	IE	HP	EG	EXISTING GRADE	EROSION CONTROL FENCE	STORM DRAIN LINE	SLOPE DIRECTION	6" FLOOD DRAIN	PROPOSED SAWCUT LOCATION	SKATEPARK LIMITS OF CONSTRUCTION
GRADING NOTES

- THIS PLAN PROVIDES GENERAL GRADING INFORMATION. ALL SURVEYING SHALL BE THE RESPONSIBILITY OF THE CONTRACTOR.
- EXPORTATION OF SOIL WHICH MAY BE NECESSARY TO MEET THE GRADES SHOWN ON THIS PLAN SHALL BE THE RESPONSIBILITY OF THE CONTRACTOR AND SHALL BE PART OF THIS CONTRACT.
- CONTRACTOR SHALL BE RESPONSIBLE FOR VERIFICATION OF THE LOCATION OF ALL EXISTING UTILITIES IN THE FIELD LOCATIONS SHOWN ON THE PLANS ARE APPROXIMATE AND FOR GENERAL INFORMATION ONLY.
- ALL HIGH POINTS, LOW POINTS OR GRADE BREAKS ON CONCRETE SURFACES SHALL HAVE A SMOOTH CURVE. CONCRETE SHALL NOT BE BUILT TO A POINT.
- THE CONTRACTOR SHALL MATCH THE NEW GRADES WITHIN THE LIMITS OF WORK TO THE EXISTING GRADES.
- CONTRACTOR SHALL PROVIDE SECURITY BARRIER DURING CONSTRUCTION & EROSION CONTROL FENCING REQUIRED TO BE IN PLACE PRIOR TO ANY SITE DRAINAGE BEHIND WALLS & TRANSITION RAMP IS AT THE DISCRETION OF THE CONTRACTOR.
- EROSION CONTROL FENCING REQUIRED TO BE IN PLACE PRIOR TO ANY SITE DRAINAGE BEHIND WALLS & TRANSITION RAMP IS AT THE DISCRETION OF THE CONTRACTOR.
- EROSION CONTROL FENCING REQUIRED TO BE IN PLACE PRIOR TO ANY SITE DRAINAGE BEHIND WALLS & TRANSITION RAMP IS AT THE DISCRETION OF THE CONTRACTOR.

NO	BY	DATE	DESCRIPTION	NO	BY	DATE	DESCRIPTION
1				1			
2				2			
3				3			
100				100			

January 27 2005

Mr. Tim Stepp
Montana Department of Environmental Quality
Permitting and Compliance Division
Waste and Underground Tank Management Bureau
P.O. Box 200901
Helena, Montana 59620

RE: Methane Gas Controls
Carroll College New Residence Hall
Infrastructure Improvements Project
Helena, Montana


City of Helena Project Number 02-22

Dear Tim:

Enclosed for your files are the final as-built drawings and final certification statement for the above-referenced project. Also enclosed are the as-built drawings and construction photos associated with the methane gas controls installed in association with installation of the project's storm water mainline across the old landfill under Centennial Park.

If you have any questions about this submittal or need additional information regarding the project construction, please don't hesitate to call me. Thank you for your assistance.

Sincerely,
MORRISON-MAIERLE, INC.

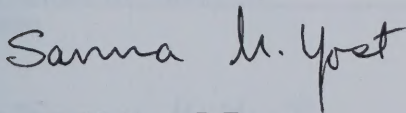

Sanna M. Yost, P.E.
Senior Civil Engineer

Enclosures: Final Certification Statement
Final As-Built Drawings (Entire Project and Methane Gas Controls)
Construction Photos of Methane Gas Controls

CC: Ms. Lynn Etchart - Carroll College (w/o Entire Project As-Built Plans)
Mr. John Sullivan - Attorney (w/o Entire Project As-Built Plans)
Mr. Ryan Leland - City of Helena (w/o Entire Project As-Built Plans)
Ms. Jodi Bingham - Hydrometrics, Inc.

90 - closed.

County L+C
Facility & # Old Helena
Closure _____ Landfarm
Finan Assur _____ Liner
GW Corr Meas _____ Methane
GW Monitoring _____ O & M
GW Reports _____ Run - On
Inspections _____
Other: _____

FINAL CERTIFICATION
CONSTRUCTION COMPLETED IN ACCORDANCE WITH
APPROVED PLANS AND SPECIFICATIONS

Project Sponsor: Carroll College

Project Name: **Carroll College Residence Hall in Helena, Montana**
Infrastructure Construction Associated with the new dorm –
Water, Sanitary Sewer, Storm Water, Streets and Parking

City of Helena Project Number: 02-22

I, Sanna M. Yost, a Registered Professional Engineer in the State of Montana, license number 7316E, do hereby state that, to the best of my knowledge, construction of the above-referenced project has been completed in accordance with the approved project plans and specifications. I further state that the record ("as-built") drawings for the work that have been completed are considered a true and accurate representation of the completed construction based on site observations of engineering inspectors and the information provided by the Owner, Carroll College, and the Contractor, Dick Anderson Construction, Inc.

Sanna M. Yost, P.E.

Name

7316PE

P.E. Number

Sanna M. Yost

Signature

January 21, 2005

Date

Morrison Maierle, Inc.
1 Engineering Place
P.O. Box 6147
Helena, MT 59604
(406) 442-3050




**Carroll College
Infrastructure Improvements
Associated with
Construction of New Residence Hall**

**Landfill Crossing Change Order
Methane Migration Controls along Storm Water
System Improvements**

**As-Built Information
Construction - January 2003**

City of Helena Project #02-22



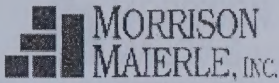

PROJECT CARROLL COLLEGE RESIDENCE HALL

BY: SMY

DATE 12-17-02

PROJ. NO. 3574


CHK

DATE

PAGE: |

OF |

AS-BUILT / 1-31-02

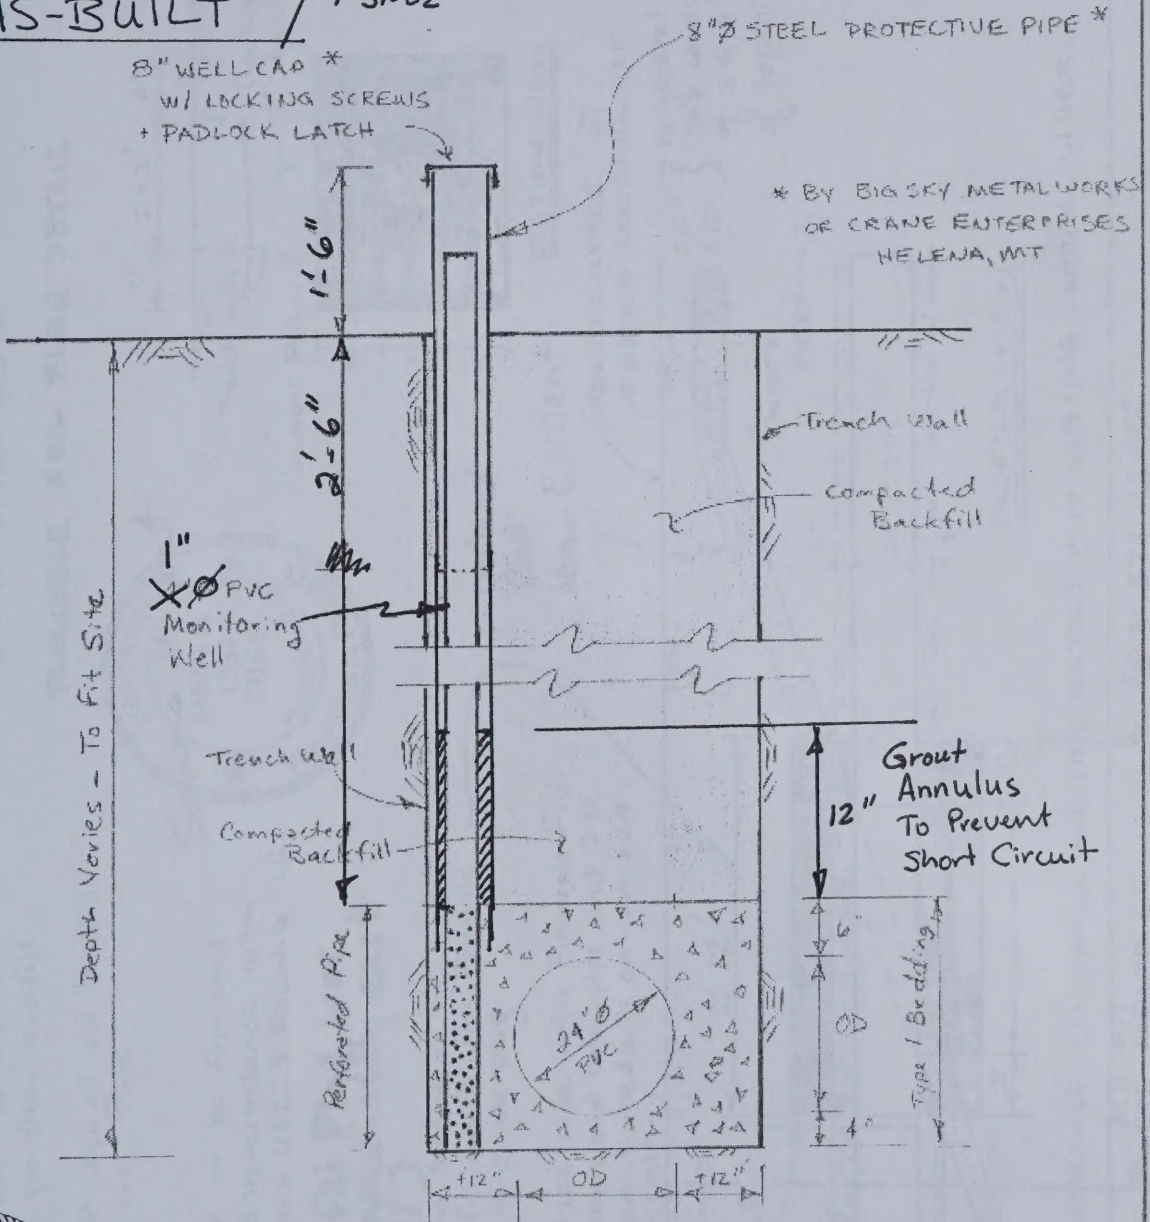

METHANE GAS MONITORING WELL APPROX. STA 113+47

(Locate approximately 10 ft west of landfill cap perforation.)

Well perforated w/in Pipe Bedding. Extends from trench bottom to ± 12" above ground surface. Upper 4 ft within 8" steel enclosure pipe.

Carroll College/City Property Line @ STA 113+37

2002/12/20





PROJECT: CARROLL COLLEGE RESIDENCE HALL

BY: SMY

DATE 12-10-02

PROJ. NO. 3574

CHK:

DATE


PAGE:

OF


1

CARROLL COLLEGE RESIDENCE HALL PROJECT STORM DRAIN SYSTEM

FLOWABLE FILL PLUG DETAIL

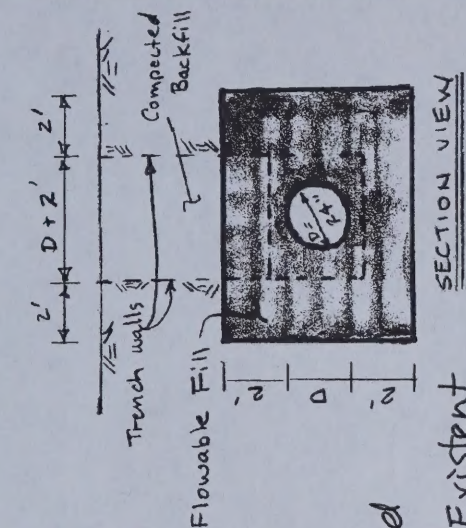

SECTION VIEW

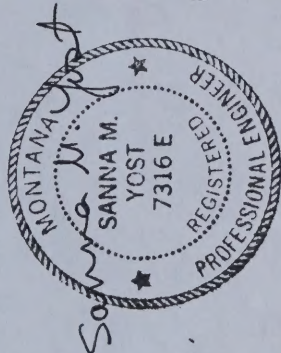

Defined Cap


Non-Existent

GROUND SURFACE

EXISTING LANDFILL CAP

In general cap consists of 2 to 3' of topsoil.

WASTE MATERIAL 2

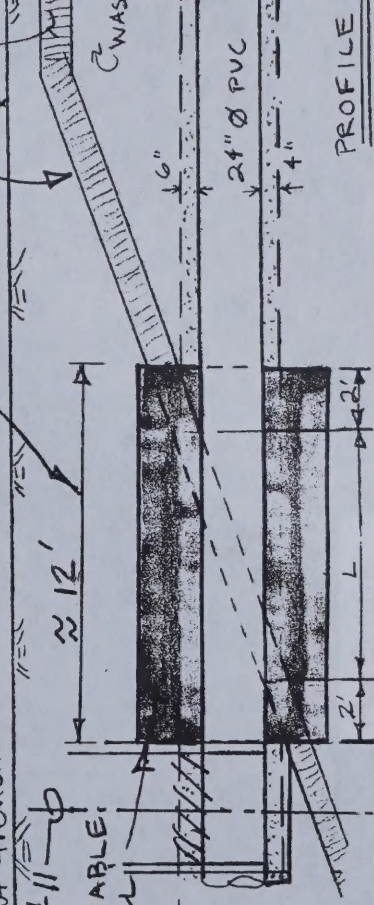

PROFILE VIEW

Purpose: To prevent migration of methane gas from landfill

Location: West edge of old landfill in Centennial Park

Note:

Flowable Fill to be furnished and installed in accordance with MPW Section 02225 Flowable Fill.

Flowable Fill Plug was installed immediately east of MH #11

Use no bedding in this area. Backfill trench with Flowable Fill to create plug

Envelope pipe with Flowable Fill. 2 ft above and below pipe and 2 ft into undisturbed soils on each side of trench.

Manhole #11 - 48" Ø FLOWABLE FILL

Type Bedding

L = LENGTH OF PERFORATION AND PIPE CONTACT WITH EXISTING LANDFILL LINER.

Approx. STA 113+85

MH #11 STA 113+70.47



Manhole #11
STA 113+70.5

Flowable Fill Plug
STA 113+73 to STA 113+85
(immediately east of MH#11)

Pipe Bedding

Manhole #10
STA 112+77


Monitoring Well
STA 113+47

Pipe Bedding

Manhole #11
STA 113+70.5

Flowable Fill Plug
STA 113+73 to STA 113+85
(immediately east of MH#11)


2003

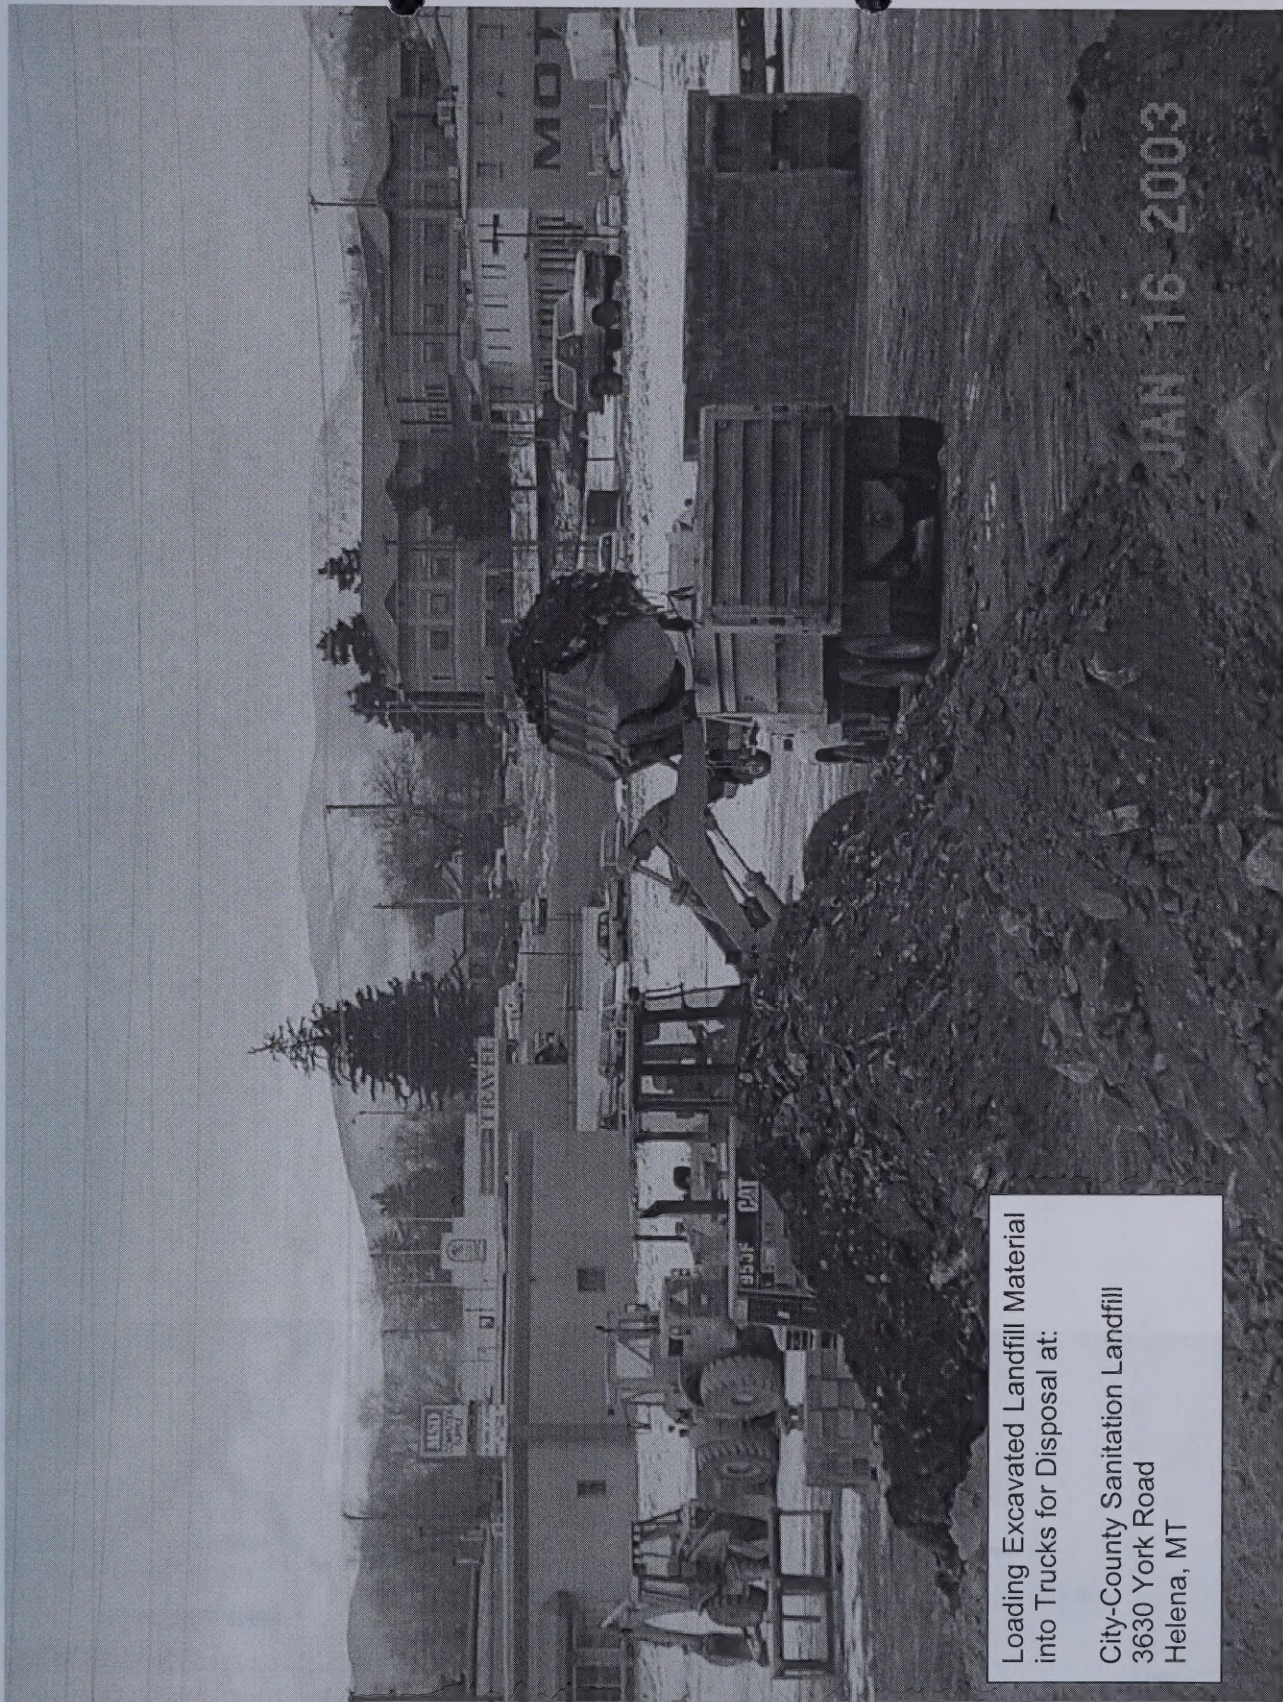

Loading Excavated Landfill Material
into Trucks for Disposal at:

City-County Sanitation Landfill
3630 York Road
Helena, MT

AS-BUILT

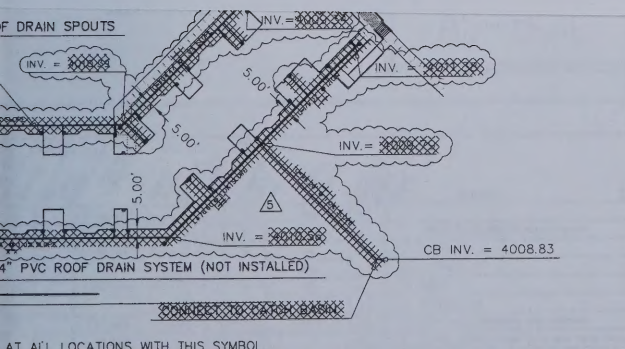


AT ALL LOCATIONS WITH THIS SYMBOL.

DRAIN SYSTEM

CONSTRUCT UP FROM 1.0' FROM CENTERLINE OF PARKING LOTS AS FOLLOWS:

1. OVERLAP CENTERLINE OF PARKING LOT 1.0' WITH FIRST PASS OF PAVING MACHINE.
2. HAND RAKE PAVEMENT EDGE AT CENTERLINE 4 HORIZONTAL TO 1 VERTICAL (4:1).
3. MAKE SECOND PASS WITH PAVING MACHINE AT CENTERLINE OF PARKING LOT PRIOR TO FINAL COMPACTION ROLLING AND FINISH ROLLING FIRST PASS.







THE CONTRACTOR MAY PROPOSE AN ALTERNATE METHOD FOR CONSTRUCTION OF THE ASPHALT JOINT IN THE CENTER OF THE PARKING LOTS FOR REVIEW AND APPROVAL BY THE ENGINEER. COLD JOINTS AND/OR VERTICAL BUTT JOINTS ARE NOT ALLOWED FOR ASPHALT PAVEMENT JOINTS AT THE CENTERLINE OF THE PARKING LOTS.

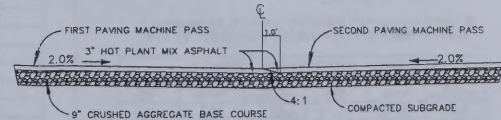


OPTION 1 ASPHALT PAVEMENT
HOT JOINT DETAIL

NTS


DRAWING AND PAVING PLAN AS-BUILT DRAWING	
DATE	CHK'D
DATE	JPS
SCALE	1"=50'-0"
CAD FILE	
DRAWING NO.	C2.0
PROJECT	3574
REV.	3

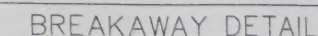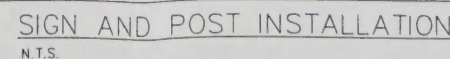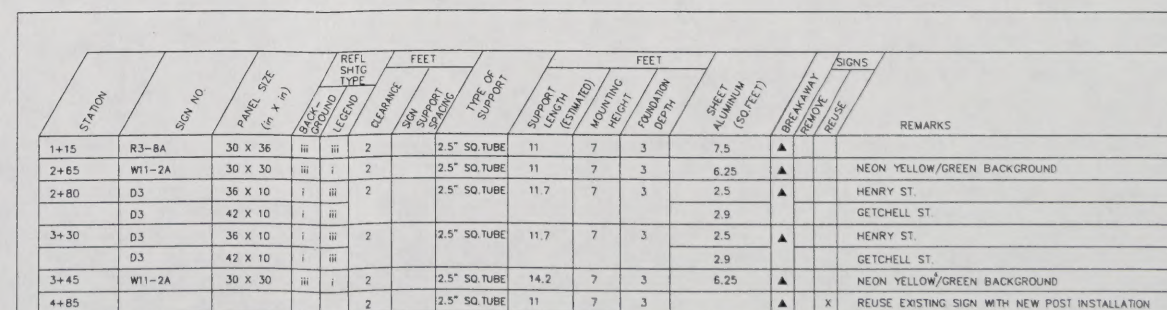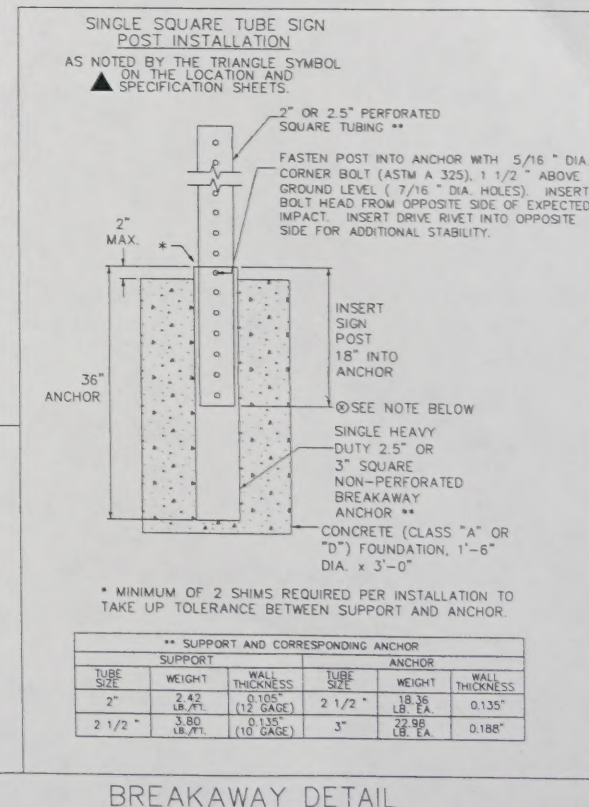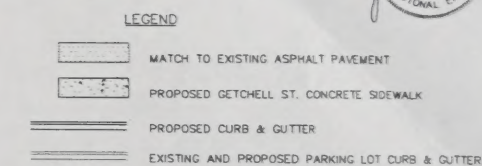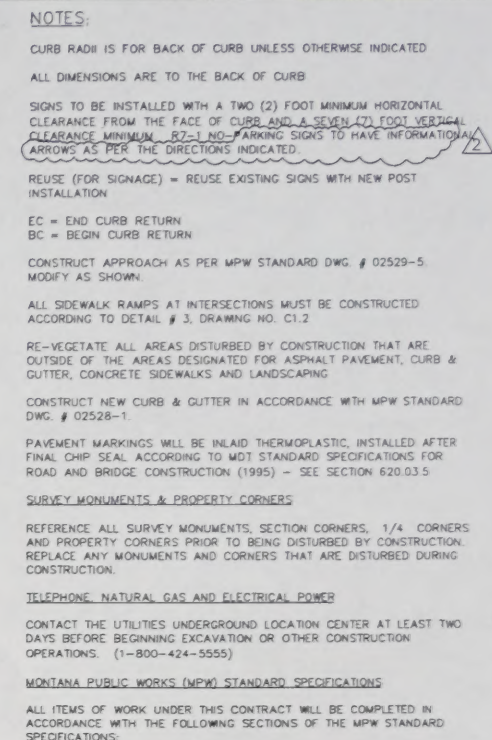

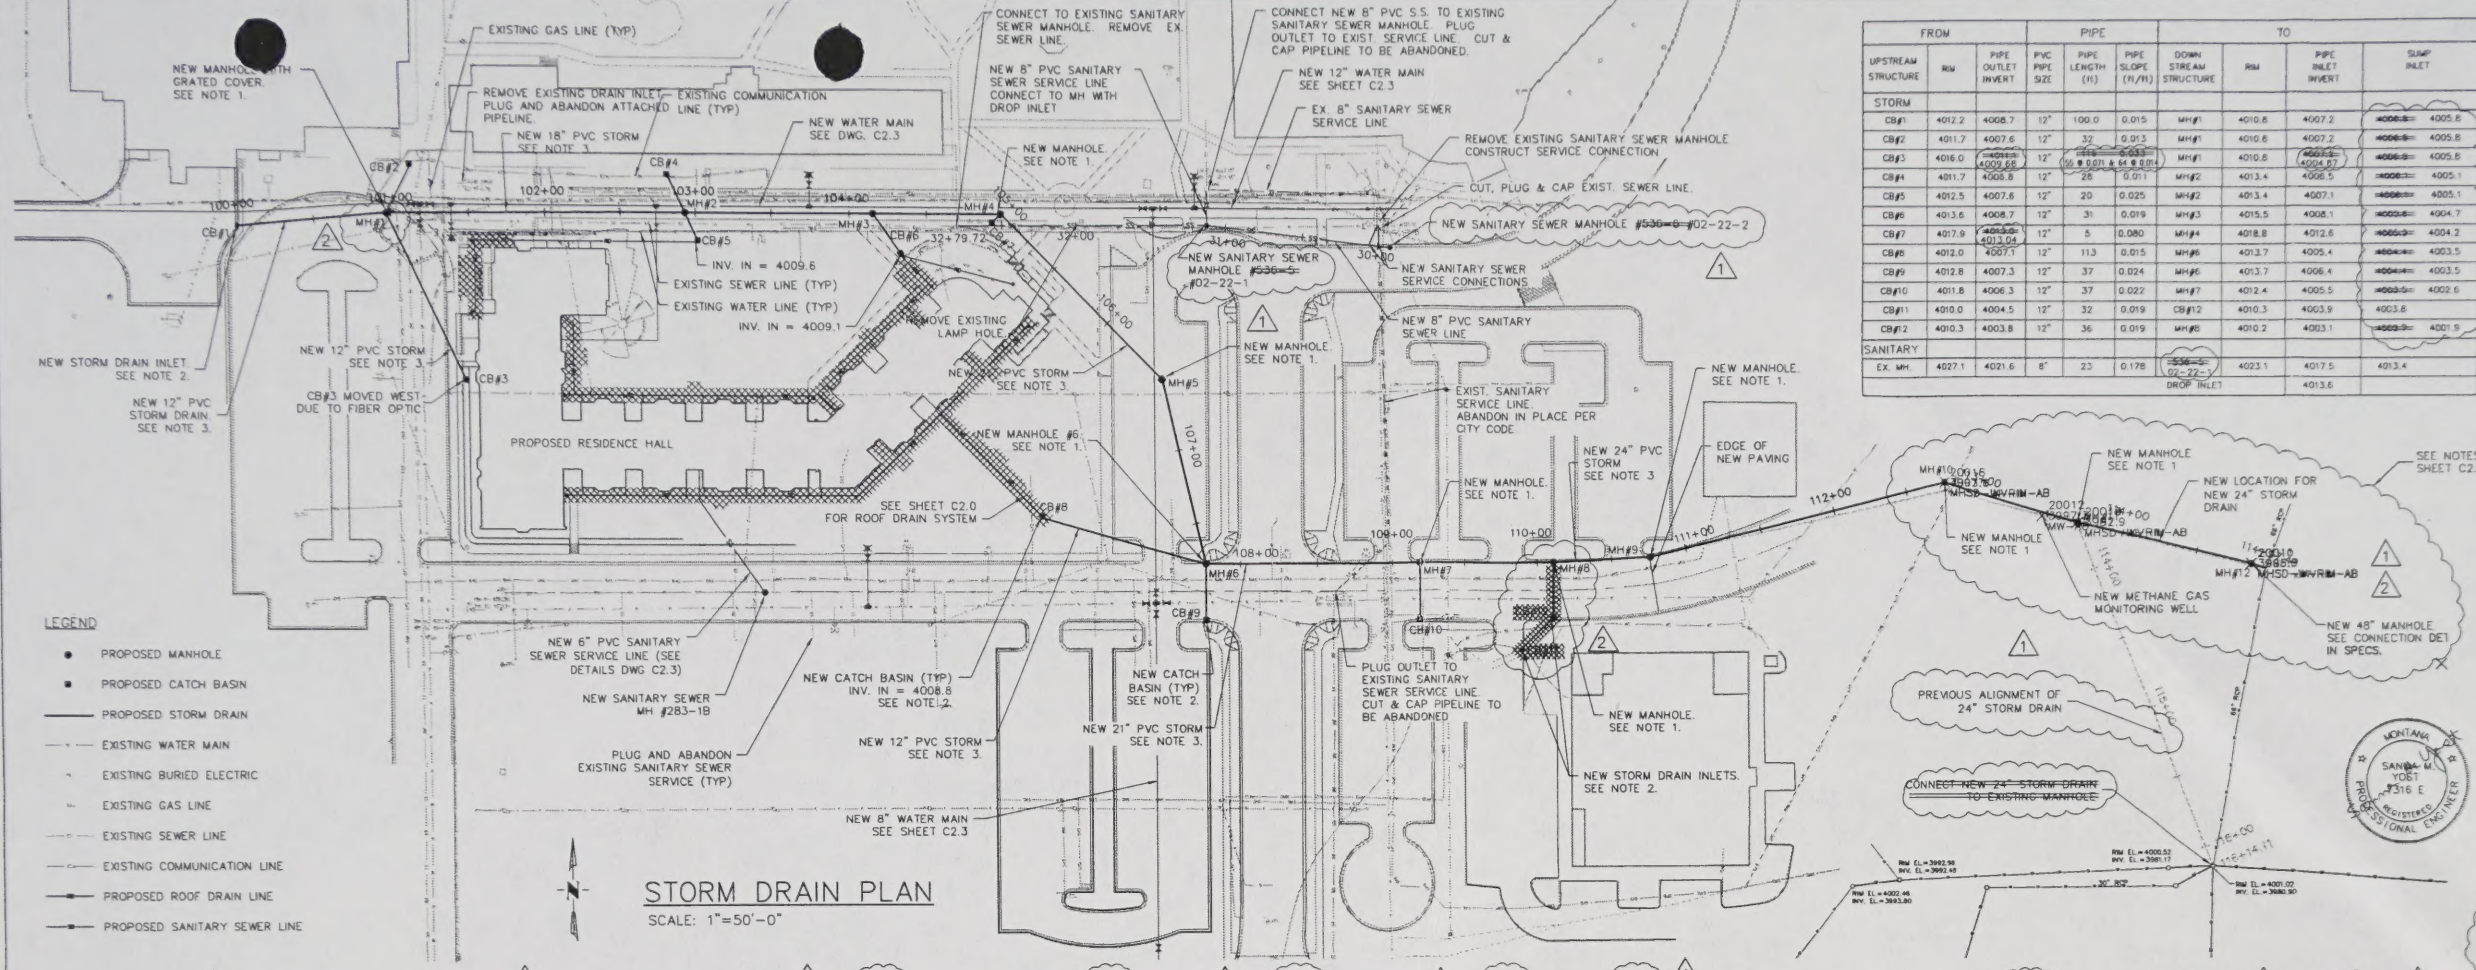


FROM			PIPE			TO			
UPSTREAM STRUCTURE	RM	PIPE OUTLET INVERT	PIPE SIZE	PIPE LENGTH (ft)	PIPE SLOPE (ft/ft)	DOWN STRUCTURE	RM	PIPE INLET	SUMP INVERT
STORM									
CB#1	4012.2	4008.7	12"	100.0	0.015	MFG#1	4010.8	4007.2	4008.8
CB#2	4011.7	4007.6	12"	32	0.013	MFG#1	4010.8	4007.2	4008.8
CB#3	4010.6	4006.8	12"	28	0.011	MFG#1	4010.8	4006.8	4008.8
CB#4	4011.7	4008.8	12"	28	0.011	MFG#2	4013.4	4006.5	4008.8
CB#5	4012.5	4007.6	12"	20	0.025	MFG#2	4013.4	4007.1	4008.8
CB#6	4013.6	4008.7	12"	31	0.019	MFG#3	4015.5	4008.1	4008.8
CB#7	4012.9	4008.0	12"	5	0.080	MFG#4	4018.8	4012.6	4008.8
CB#8	4013.0	4007.4	12"	113	0.015	MFG#6	4013.7	4005.4	4008.8
CB#9	4012.8	4007.3	12"	37	0.024	MFG#6	4013.7	4006.4	4008.8
CB#10	4011.8	4006.3	12"	37	0.022	MFG#7	4012.4	4005.5	4008.8
CB#11	4010.0	4004.5	12"	32	0.019	CB#12	4010.3	4003.9	4003.8
CB#12	4010.3	4003.8	12"	36	0.019	MFG#8	4010.2	4003.1	4003.9
SANITARY									
EX. MH	4027.1	4021.6	8"	23	0.178	5506-SIS-02-27-23 DROP INLET	4023.1	4017.5	4013.4


- STORM DRAIN AND SANITARY SEWER NOTES:**
1. CONSTRUCT NEW STORM DRAIN MANHOLE IN ACCORDANCE WITH MPW STANDARD DRAWING NUMBER 02722-1 THRU 8.
 2. CONSTRUCT NEW STORM DRAIN INLET IN ACCORDANCE WITH MPW STANDARD DRAWING NUMBER 02721-1 AND 02721-2 OR AS NOTED.
 3. CONSTRUCT NEW STORM DRAIN PIPE IN ACCORDANCE WITH MPW STANDARD DRAWING NUMBER 02221-1, 02221-2, AND 02713-2. ALL NEW PIPE FROM NEW CATCH BASINS TO NEW MANHOLES TO BE 12" PVC.
 4. SEE SHEET C2.0 FOR ROOF DRAIN SYSTEM.
 5. PLUG AND ABANDON EXISTING SANITARY SEWER PIPELINE.
 6. ABANDON EXISTING SEWER SERVICES THAT WILL NO LONGER BE IN USE, PER CITY OF HELENA CODE.
 7. RE-SEED ALL AREAS DISTURBED BY CONSTRUCTION VEGETATION THAT ARE OUTSIDE OF THE AREAS DESIGNATED FOR ASPHALT PAVEMENT, CURB & GUTTER, CONCRETE SIDEWALKS AND LANDSCAPING.
 8. TYPE A TRENCH BACKFILL WILL BE USED ON AREAS PROPOSED FOR PAVEMENT. TYPE B TRENCH BACKFILL WILL BE USED ONLY IN LANDSCAPED AREAS NOT DESIGNATED FOR FUTURE PAVING.
 9. TYPE 1 PIPE BEDDING INCLUDES THE MATERIAL PLACED 4 INCHES BELOW THE BOTTOM OF THE PIPE TO 6 INCHES ABOVE THE PIPE.
 10. ALL EXPLORATORY EXCAVATION REQUIRED FOR THE LOCATION OF EXISTING UNDERGROUND UTILITIES SHALL BE INCLUDED AS PART OF THE CONTRACT PRICE. NO EXTRA COMPENSATION WILL BE MADE FOR THIS WORK.
 11. TRENCH DIMENSIONS - MAXIMUM TRENCH WIDTH SHALL BE 7 FEET. IT IS THE RESPONSIBILITY OF THE CONTRACTOR TO COMPLY WITH CURRENT OSHA REGULATIONS. SUBSURFACE CONDITIONS SHOULD BE OBSERVED DURING EXCAVATION IN ORDER TO MAKE ADJUSTMENTS TO CONSTRUCTION PROCEDURES THAT WILL ENSURE WORKER SAFETY.
 12. SUBMIT MDCO STORM WATER PERMIT FOR CONSTRUCTION ACTIVITIES PERMIT AND EROSION CONTROL PLAN AT LEAST 30 DAYS PRIOR TO START OF CONSTRUCTION.
 13. ASSURE LARGE DIAMETER PVC PIPE MEETS ASTM F679, 1-1 WALL THICKNESS (SDR35).
 14. CONTRACTOR SHALL FIELD VERIFY SIZE, MATERIAL AND LOCATION OF EXISTING STORM DRAIN MANHOLE IN CENTENNIAL PARK. CONTRACTOR SHALL FURNISH SPECIAL FITTINGS AND ALL OTHER MATERIAL REQUIRED FOR CONNECTING THE NEW STORM TO THE EXISTING MANHOLE.
 15. CONTRACTOR TO FIELD VERIFY DEPTH OF ALL PERTINENT EXISTING UTILITIES.
 16. AS IS A STANDARD REQUIREMENT IN THE CITY OF HELENA, ALL NEW STORM AND SEWER MAINS ARE TO BE INSTALLED WITH A TV CAMERA AFTER FINAL INSTALLATION, AND A TAPE PROVIDED TO THE CITY.
 17. AS IS REQUIRED FOR ALL CONSTRUCTION PROJECTS IN MONTANA THAT DISTURB MORE THAN FIVE ACRES, THE CONTRACTOR MUST SUBMIT AN APPROVABLE EROSION CONTROL PLAN AND OBTAIN A DEC CONSTRUCTION STORM WATER DISCHARGE PERMIT PRIOR TO DISTURBANCE.

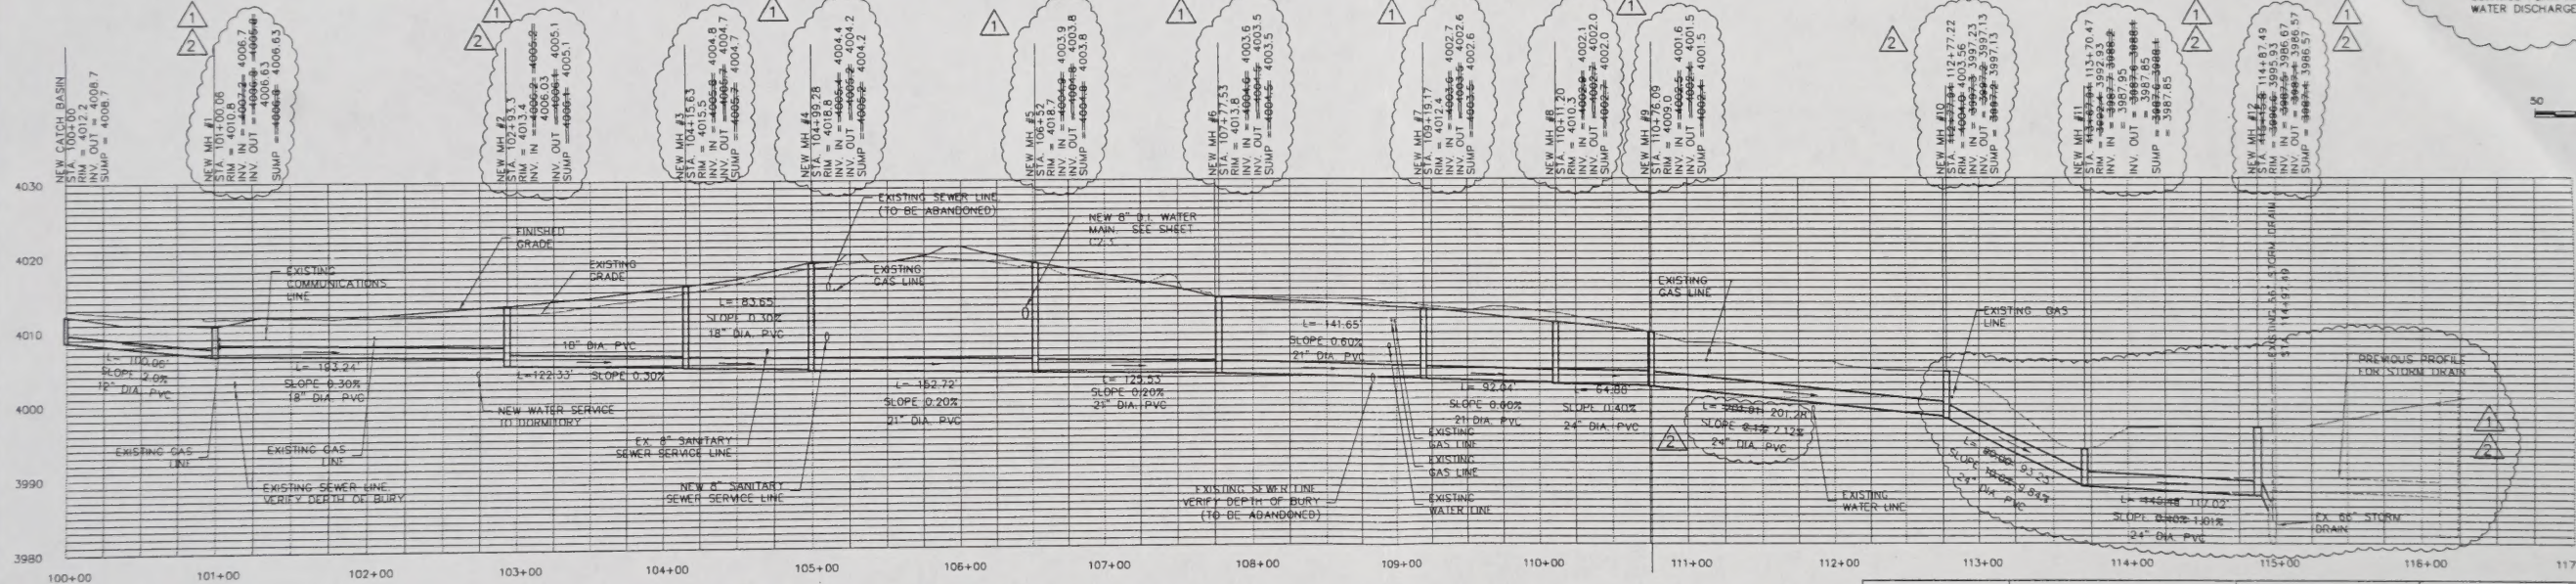

MANHOLE #	TYPE	FRAME/GRATE *	INLET STRUCTURE	RIM ELEV.
1	COVER GRATE	MCI-301/MCI 301-D1	48" DIA. MH	4010.8
2	SOLID COVER - STORM	MCI-301/MCI 301-A	48" DIA. MH	4013.4
3	SOLID COVER - STORM	MCI-301/MCI 301-A	48" DIA. MH	4015.5
4	SOLID COVER - STORM	MCI-301/MCI 301-A	48" DIA. MH	4018.8
5	COVER GRATE	MCI-301/MCI 301-D1	48" DIA. MH	4018.7
6	COVER GRATE & CURB BOX	IFCO 515-7	48" DIA. MH	4013.6
7	COVER GRATE & CURB BOX	IFCO 515-7	48" DIA. MH	4012.4
8	COVER GRATE & CURB BOX	IFCO 515-7	48" DIA. MH	4010.3
9	COVER GRATE & CURB BOX	IFCO 515-7	48" DIA. MH	4009.0
10	COVER GRATE & CURB BOX	IFCO 515-7	48" DIA. MH	4004.0
11	COVER GRATE	MCI-301/MCI 301-D1	48" DIA. MH	3992.4
12	COVER GRATE	MCI-301/MCI 301-D1	48" DIA. MH	3996.0
CATCH BASIN #				
1	COVER GRATE & CURB BOX	IFCO 515-7	48" DIA. MH	4012.2
2	COVER GRATE	MCI-301/MCI 301-D1	MPW STD. 30" DIA RISER	4011.7
3	COVER GRATE	MCI-301/MCI 301-D1	MPW STD. 30" DIA RISER	4016.0
4	COVER GRATE	MCI-301/MCI 301-D1	MPW STD. 30" DIA RISER	4011.7
5	COVER GRATE	MCI-301/MCI 301-D1	MPW STD. 30" DIA RISER	4012.5
6	COVER GRATE	MCI-301/MCI 301-D1	MPW STD. 30" DIA RISER	4013.6
7	COVER GRATE	MCI-301/MCI 301-D1	MPW STD. 30" DIA RISER	4012.9
8	COVER GRATE	MCI-301/MCI 301-D1	MPW STD. 30" DIA RISER	4012.0
9	COVER GRATE & CURB BOX	IFCO 515-7	48" DIA. MH	4012.8
10	COVER GRATE & CURB BOX	IFCO 515-7	48" DIA. MH	4011.8
11	COVER GRATE & CURB BOX	IFCO 515-7	48" DIA. MH	4010.0
12	COVER GRATE & CURB BOX	IFCO 515-7	48" DIA. MH	4010.3
SEWER M.H. #				
283-18	SOLID COVER - SEWER	MCI-301/MCI 301-A	48" DIA. MH	4016.3
536-5	02-22-1	MCI-301/MCI 301-A	48" DIA. MH	4023.1
536-6	02-22-2	MCI-301/MCI 301-A	48" DIA. MH	4024.2

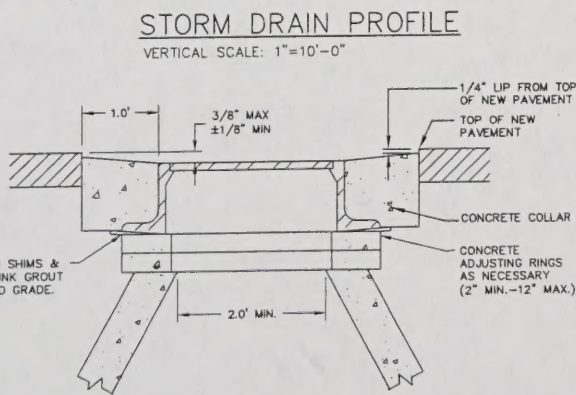

- NOTES:**
1. ADJUST MANHOLES UPWARD WITH ADJUSTING RINGS UNDER FRAME.
 2. ADJUST MANHOLE DOWNWARD BY REMOVING CONE AND BARREL SECTIONS AS NECESSARY AND REPLACING WITH SECTIONS OF LENGTH REQUIRED TO MATCH GRADE.
 3. SLOPE MANHOLE FRAME AS REQUIRED TO MATCH SLOPE OF STREET.
 4. FINAL MANHOLE ADJUSTMENT SHALL BE MADE AFTER PAVING.
- MANHOLE COVER ADJUSTMENT**
NOT TO SCALE

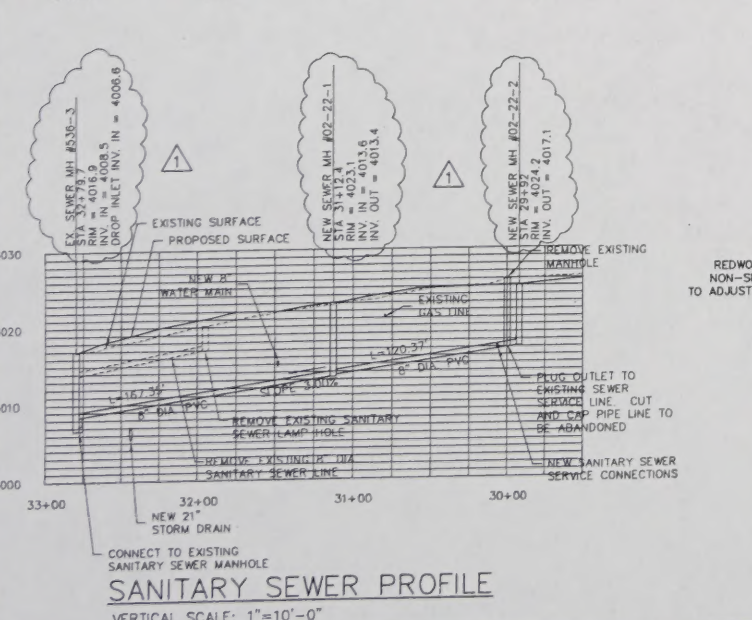

REVISIONS


NO.	DATE	BY	REVISIONS
1	11/2002	SM	MANHOLE INVERTS ADJUSTED AND STORM DRAIN RE-ALIGNMENT
2	12/2003	SM	ADJUSTED MANHOLE #1 & #2 INVERTS, RE-ALIGN MANHOLES #1, #10, #11, & #12, AND INDICATE CIV 11, & 12 NOT INSTALLED

ENGINEER
MORRISON MAERLE, INC.
A PROFESSIONAL ENGINEERING FIRM
1010 N. 10TH AVENUE, SUITE 110, HELENA, MONTANA 59601
406-261-1144
FAX 406-261-1145
WWW.MORRISONMAERLE.COM

NEW RESIDENCE HALL FOR CARROLL COLLEGE
HELENA, MONTANA


AS-BUILT

Performa
STORM DRAIN PLAN AND PROFILE AND SANITARY SEWER AS-BUILT DRAWING
DATE: 9/24/02
SCALE: 1"=50'-0"
C2.2
PROJECT: 3574

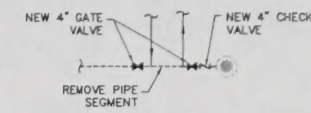


DETAIL A

NOT TO SCALE

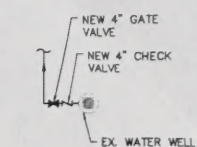


DETAIL B

NOT TO SCALE

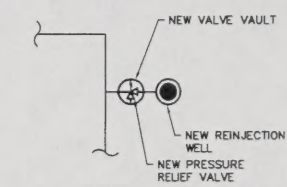

DETAIL C

NOT TO SCALE

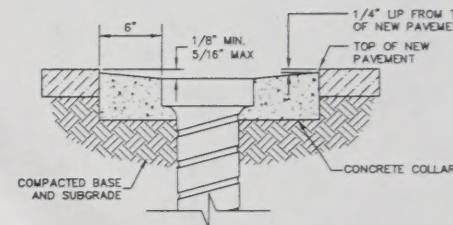


NOTES:

1. ADJUST WATER VALVES UPWARD OR DOWNWARD AS REQUIRED.
2. FINAL ADJUSTMENT SHALL BE MADE AFTER PAVING.


WATER VALVE BOX ADJUSTMENT

NOT TO SCALE

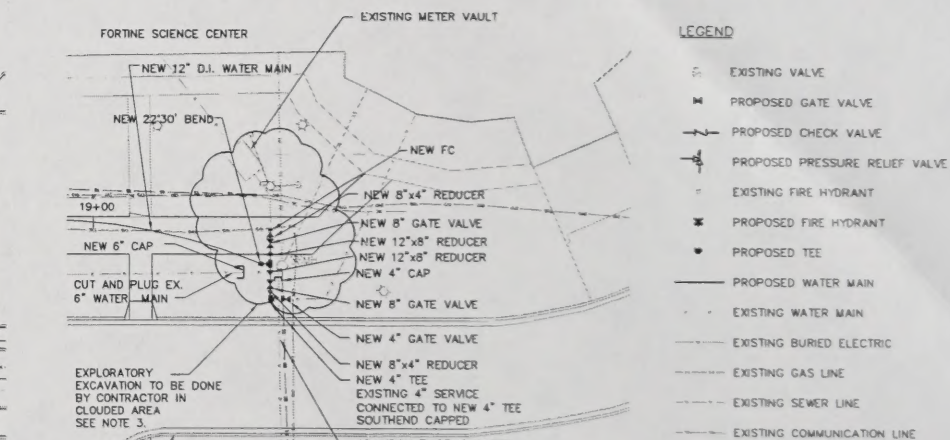


12" WATER MAIN PROFILE

VERTICAL SCALE: 1"=10'-0"

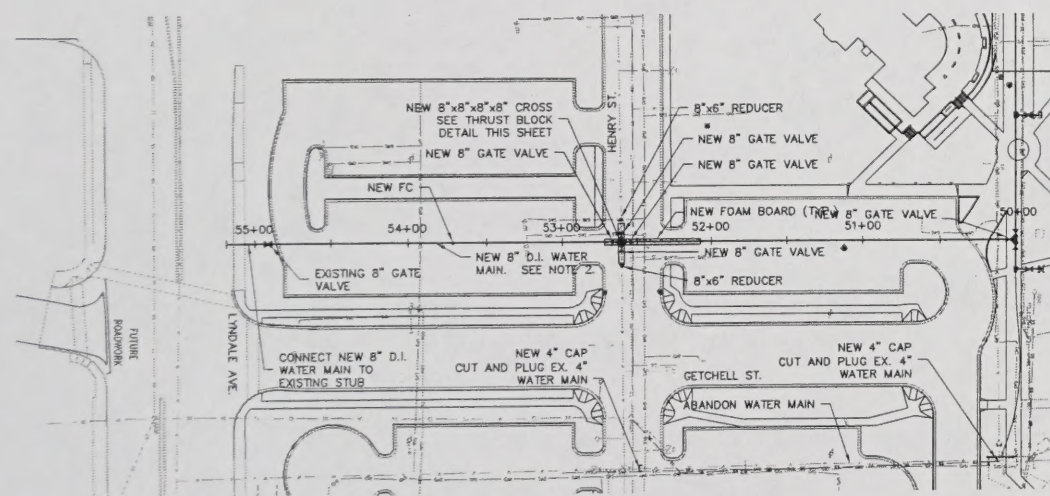


8" WATER MAIN PLAN

SCALE: 1"=50'-0"

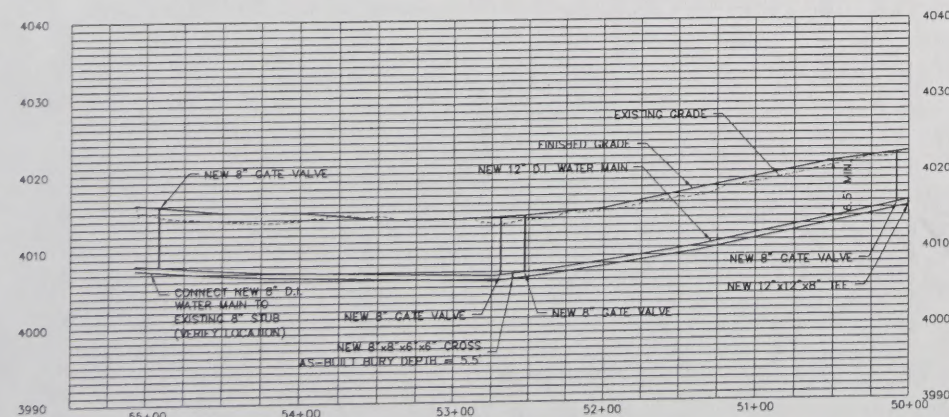


8" WATER MAIN PROFILE

VERTICAL SCALE: 1"=10'-0"

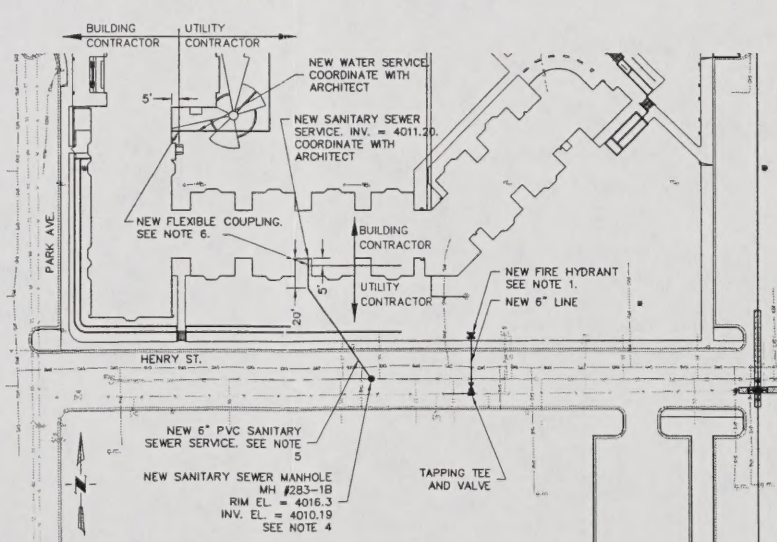


NEW HENRY ST. FIRE HYDRANT
AND SANITARY SEWER SERVICE CONNECTION

SCALE: 1"=50'-0"

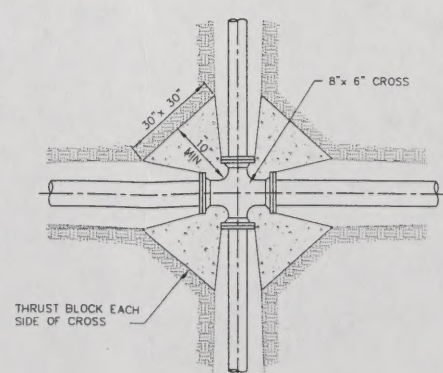


TYPICAL THRUST BLOCK AT CROSS

NOT TO SCALE

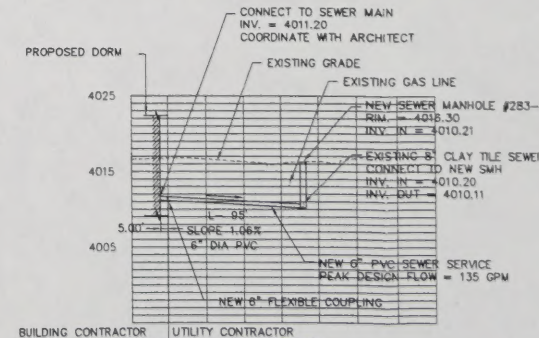

NEW 6" PVC SANITARY SEWER PROFILE

NOT TO SCALE

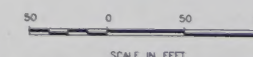

SCALE IN FEET

WATER LINE PLAN AND PROFILE SANITARY SEWER SERVICE CONNECTION AS-BUILT DRAWING		Performa[®] 301 N. BROADWAY, SUITE 210 P.O. BOX 5154 DEER BEACH, MISSOURI 64155 314-339-2245 FAX: 314-339-2399 www.performac.com		 MORRISROE & MAIERLE, INC. Professional Engineer 610 N. 10th Street Helena, MT 59601 Phone: (406) 442-3560 Fax: (406) 442-1982 LICENSED PROFESSIONAL ENGINEER, MT. 0001		ENGINEERS ARCHITECTS SURVEYORS PLANNERS Founded 1945		 NEW RESIDENCE HALL FOR CARROLL COLLEGE HELENA, MONTANA		NO. 1 CITY OF HELENA SUPPLEMENTAL COMMENTS #2 2 STORM DRAIN CHANGES HELENA, MONTANA 3 AS-BUILT CONSTRUCTION		REVISIONS BY DATE NO.		REVISIONS BY DATE NO.		DATE	
DRAWING DATE: 9-06-02 SCALE: 1"=50'-0" C&P FILE: _____		JPS CHK'D: TRB		PROJECT: 3574 REV.: _____		DRAWING No. C2.3		NO. 1 CITY OF HELENA SUPPLEMENTAL COMMENTS #2 2 STORM DRAIN CHANGES HELENA, MONTANA 3 AS-BUILT CONSTRUCTION		REVISIONS BY DATE NO.		REVISIONS BY DATE NO.		DATE			

6" DIAMETER (NOM.) LANDSCAPING ROCK/RIPPRAP

24" 24"

FACE OF SLOPE

4

1

3" THK. GRAVEL

OUTLET CHANNEL - SECTION B-B

NOTE:
LOCATION OF UTILITIES
APPROXIMATE. CONTRACTOR
TO FIELD VERIFY ALL UTILITY
LOCATIONS PRIOR TO
CONSTRUCTION.

EXISTING WATER LINE. —
PROVIDE 2" THK. INSULATION
BOARD OVER PIPE WHERE
COVER IS LESS THAN 6 FT.

10:1 SLOPE

EXISTING GRADE
I.E. 4002.5

FINISH GRADE

4'

TOP OF BERM EL. 4005.0

3:1 SLOPE

6" DIA. PVC

TRIANGULAR
COBBLE-LINED CHANNEL

MH #11

65'±

I.E. 4003.0

SECTION A-A AT STA. 10+00

SECTION A-A AT STA. 10+00

OUTLET CHANNEL - SECTION B-B

REVEGETATE ALL
DISTURBED AREAS NOT
WITHIN ROADWAY

SPREAD EXCAVATED
EXCESS GRADE
MATERIAL ALONG BANK
THIS AREA UNLESS
OTHERWISE DIRECTED.

STORM RETENTION POND
REQUIRED VOLUME 7279 C.F.

EXISTING WATER LINE. PROVIDE 2" THK. _____
INSULATION BOARD OVER PIPE WHERE COVER IS _____
LESS THAN 6 FT. _____

WATER
BARN

REFERENCE COR.
N. 5420.91
E. 5739.23

KTVH SATELLITE
FARM

SANITARY SEWER
CLEAN OUT

1/ SANITARY SEWER
1/ MH #03-24-1

4 FT. WIDE TOP OF
BERM ELEV.=4005.0
EARTH BERM TO BE
CONSTRUCTED TO 95%
MAXIMUM DRY DENSITY.

- SANITARY SEWER
MH #03-24-2

- 6" DIA, SC
PVC L=44

— TRIANGULAR COBBLE-LINED 6"
DEEP CHANNEL. 4 FT. WIDE/4:1
SIDE SLOPES FROM PIPE OUTLET
TO MH #11. L= 40'

STORM
MH #11

INSTALL TEMPORARY SILT
FENCE. TO REMAIN IN PLACE
UNTIL VEGETATION
ESTABLISHED. (LOCATE
FENCE DOWNHILL OF ALL
DISTURBED SOILS)

STORM -
MH #12

GRADING COORDINATES		
PT. NO.	NORTHING	EASTING
1	5397.05	5774.92
2	5421.92	5751.71
3	5439.02	5768.64
4	5412.80	5794.70
5	5457.23	5785.52
6	5422.11	5820.18
7	5516.46	5833.24
8	5502.23	5875.91
9	5526.88	5880.63
10	5540.29	5839.68
11	5564.61	5846.74
12	5576.11	5850.60
13	5551.58	5886.06

POND VOLUME		
CONTOUR	AREA (SQ. FT.)	VOL. (CU. FT.)
4003	4992	1248
4004	8772	8130
4005	13,053	19,043

EARTHWORK QUANTITY ESTIMATES

EXCAVATION	~300 CY
EMBANKMENT	~200 CY
ROCK RIPRAP	~4.5 CY
AGGREGATE 1 1/2" MINUS	~2.0 CY
(TYPE 1 BEDDING)	
PIPE 6" DIA SCH 40	PVC = 44 FT
(QUANTITIES FOR BID PURPOSES ONLY)	

CONSTRUCTION SPECIFICATIONS
ALL ITEMS OF WORK UNDER THIS CONTRACT
WILL BE COMPLETED IN ACCORDANCE WITH
THE FOLLOWING SECTIONS OF THE MPW
STANDARD SPECIFICATIONS:

DIVISION 1 - GENERAL REQUIREMENTS
SECTION 01500 - CONSTRUCTION AND
TEMPORARY FACILITIES



DIVISION 2 - SITE WORK
SECTION 02230 - STREET EXCAVATION,
BACKFILL AND COMPACTION
SECTION 02720 - STORM DRAIN SYSTEMS
SECTION 02910 - SEEDING

CARROLL COLLEGE STORM WATER DETENTION POND HELENA MONTANA		PROJECT NO. 0257 SHEET NUMBER 1 DRAWING NUMBER C-1																																																
DRAWN BY: JMH CHK'D. BY: SMT APPR. BY: _____ DATE: 3/2003 Q.A. REVIEW BY: _____ DATE: _____ MORRISON MAIERLE, INC. An Employee-Owned Company 910 Helena Avenue Helena MT 59604 Phone: (406) 442-3050 Fax: (406) 442-7882 ENGINEERS SCIENTISTS SURVEYORS PLANNERS SINCE 1945																																																		
REVISIONS <table border="1" style="width: 100%; border-collapse: collapse;"> <thead> <tr> <th style="width: 5%;">NO.</th> <th style="width: 45%;">DESCRIPTION</th> <th style="width: 15%;">DATE</th> <th style="width: 35%;">BY</th> </tr> </thead> <tbody> <tr><td> </td><td> </td><td> </td><td> </td></tr> <tr><td> </td><td> </td><td> </td><td> </td></tr> <tr><td> </td><td> </td><td> </td><td> </td></tr> <tr><td> </td><td> </td><td> </td><td> </td></tr> <tr><td> </td><td> </td><td> </td><td> </td></tr> <tr><td> </td><td> </td><td> </td><td> </td></tr> <tr><td> </td><td> </td><td> </td><td> </td></tr> <tr><td> </td><td> </td><td> </td><td> </td></tr> <tr><td> </td><td> </td><td> </td><td> </td></tr> <tr><td> </td><td> </td><td> </td><td> </td></tr> <tr><td> </td><td> </td><td> </td><td> </td></tr> </tbody> </table>		NO.	DESCRIPTION	DATE	BY																																													VERIFICATION SCALE: THESE PRINTS MAY BE REDUCED. LINE BELOW MEASURES ONE INCH ON ORIGINAL DRAWING. — MODIFY SCALE SCALE ACCORDINGLY
NO.	DESCRIPTION	DATE	BY																																															

Dept. of Enviro. Quality
Waste & Underground
Tank Management Bureau



SCALE: 1"=50'-0"

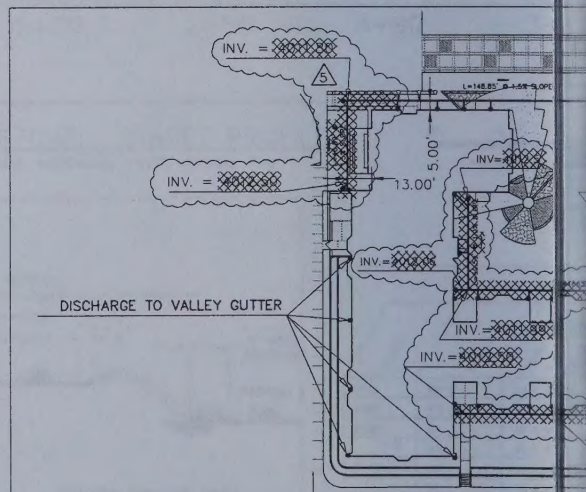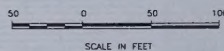

NOTE: INSERT (CAN

NTS